




SOUTH SUBURBAN ICE ARENA
AS-BUILT FLOOR PLAN
AUGUST 1989
SCALE: 1" = 8'-0"

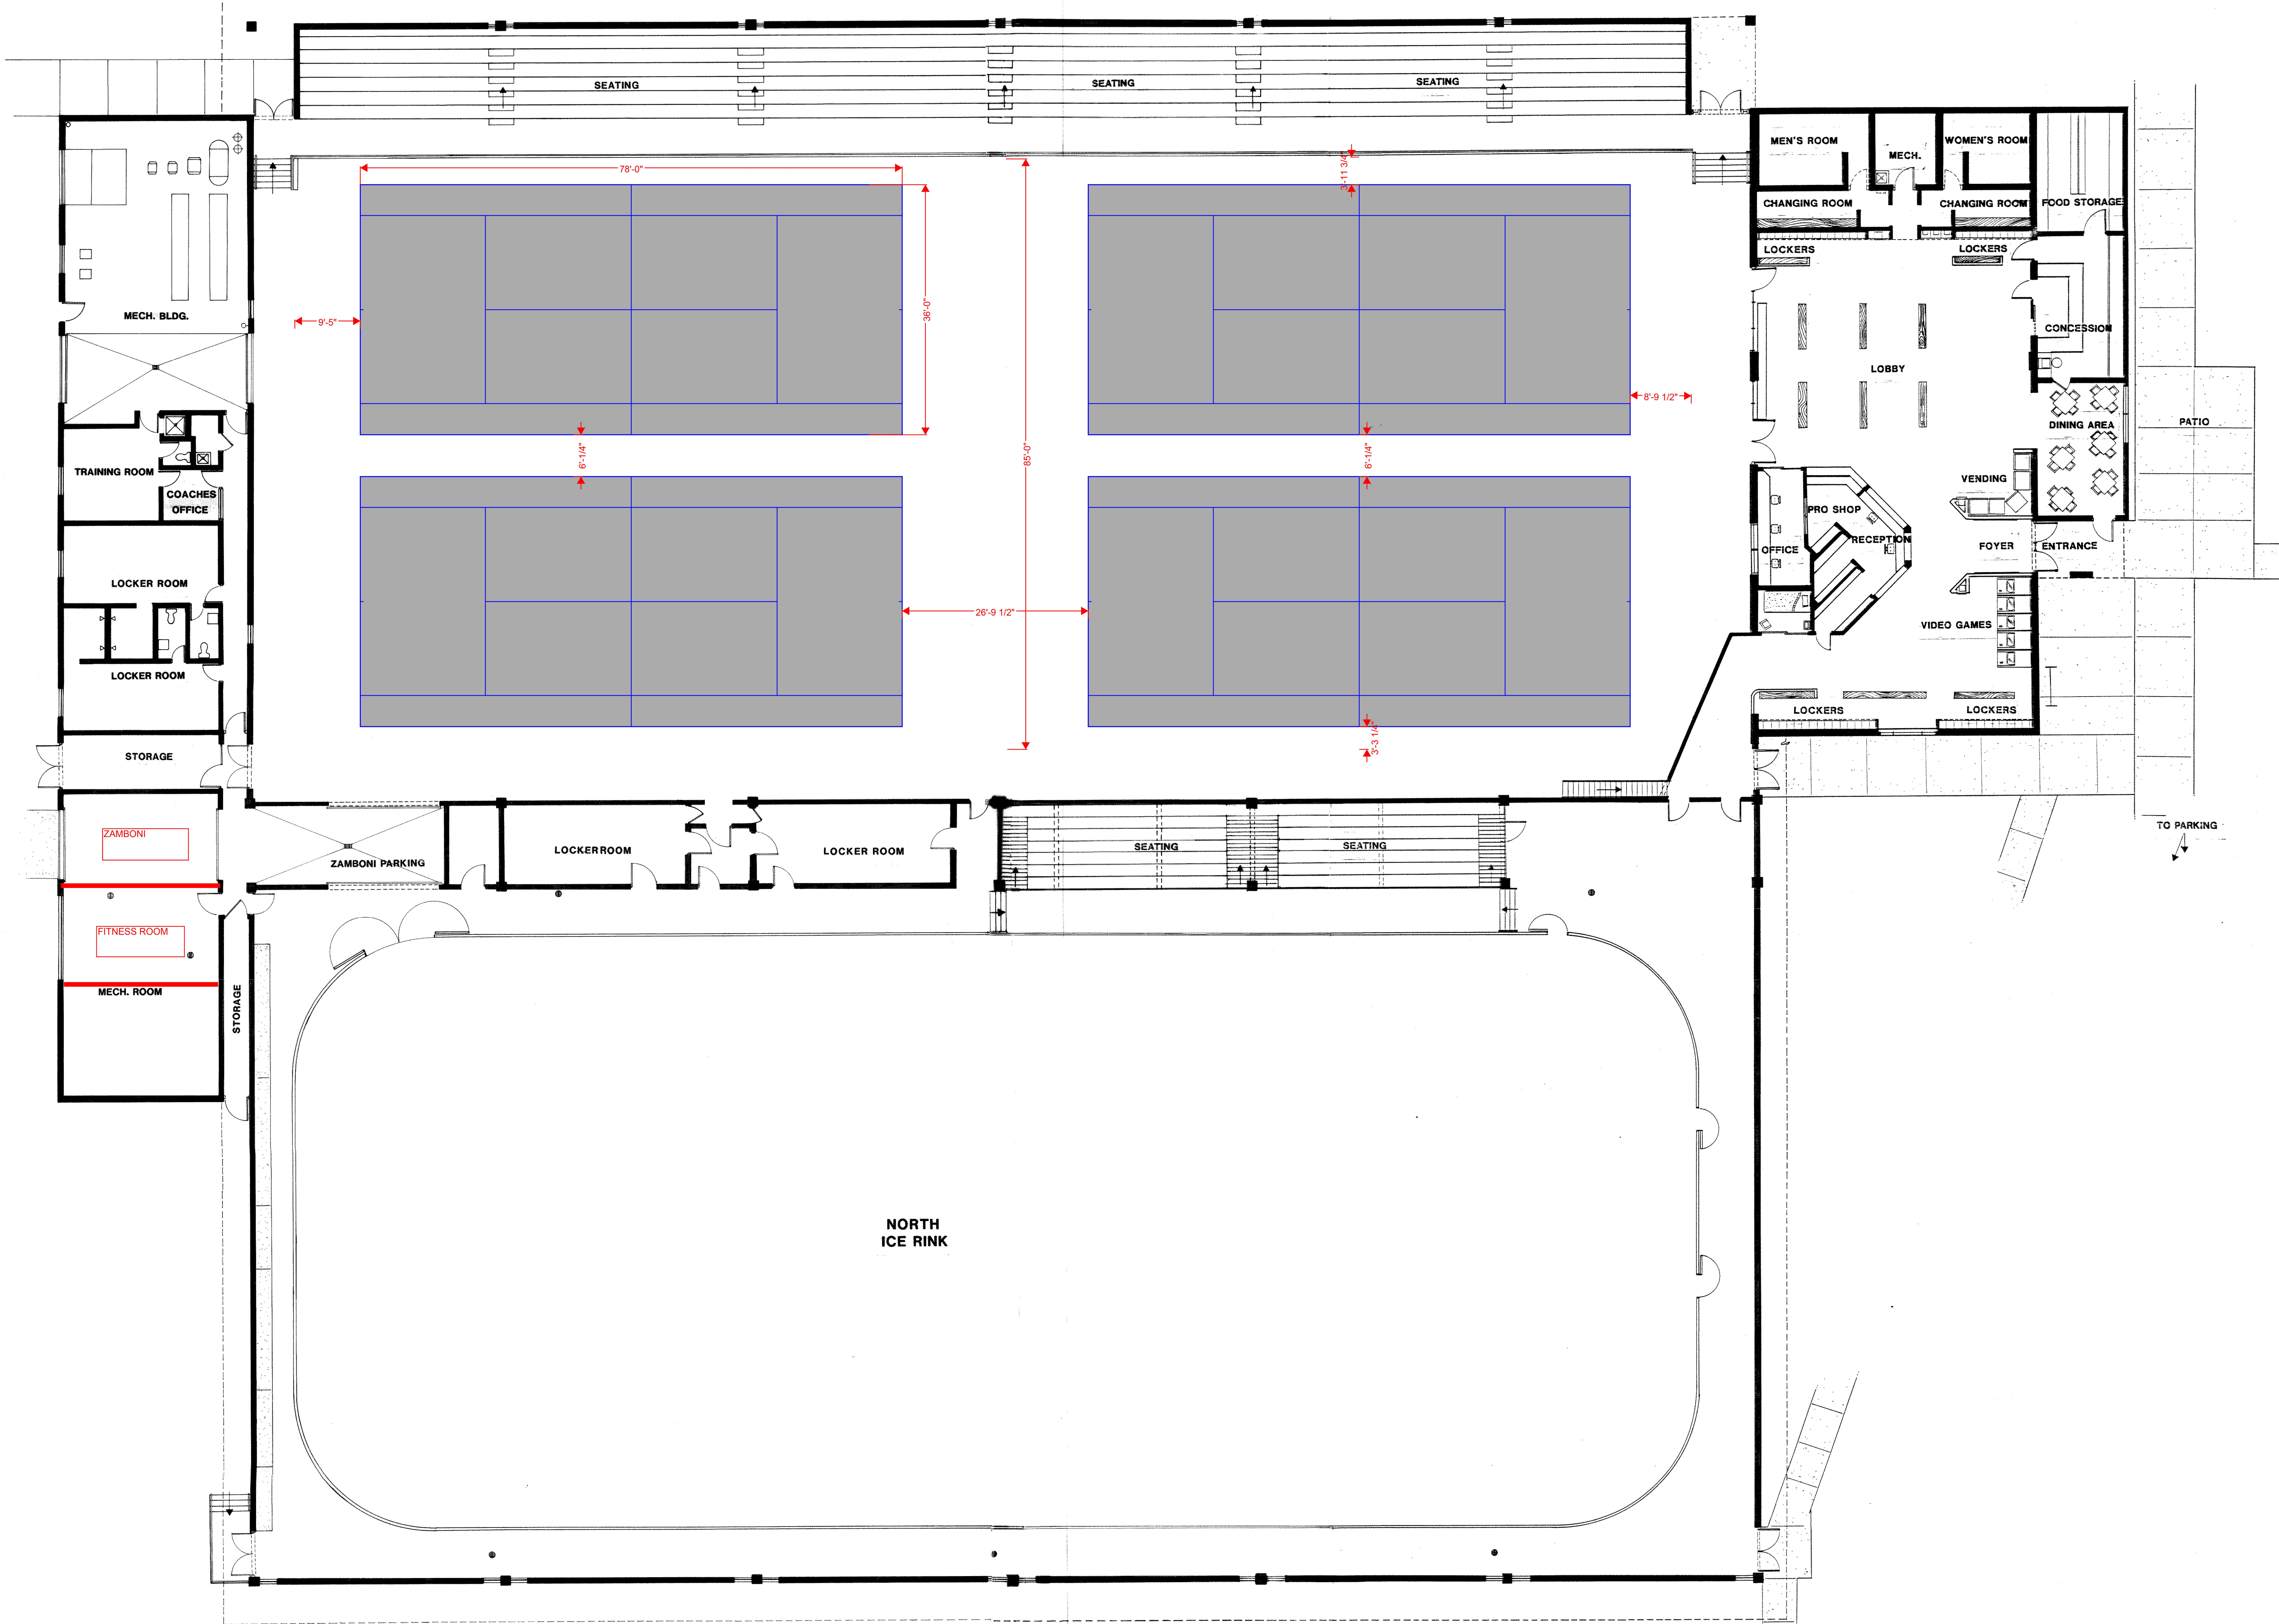